

STAGE ONE  
FLOOR PLAN  
1:100 @ A3

Note: Plan is concept. NOT AS BUILT



01 FOR APPROVAL	30/03/2025	Client: ANGLICAN NEWCASTLE ALL SAINTS ANEW
Drawing Title: FLOOR PLAN		Project: ALTERATIONS & ADDITIONS TO CHURCH - STAGE ONE
Job Number: 448	Drawing Number: CC01	Issue: 01



**IF YOU'RE NOT SURE HOW TO DO IT... DON'T DO IT... ASK!**




Assessed by Ian Childs F.IPEA; Comp.IEAust; M.FPAA; M.SFS; M.SBSE; Aff.CIBSE; Aff.AFA; NAM; NEM, ESM.



*[Handwritten signature]*

0414-472-042  
ian@childs.au

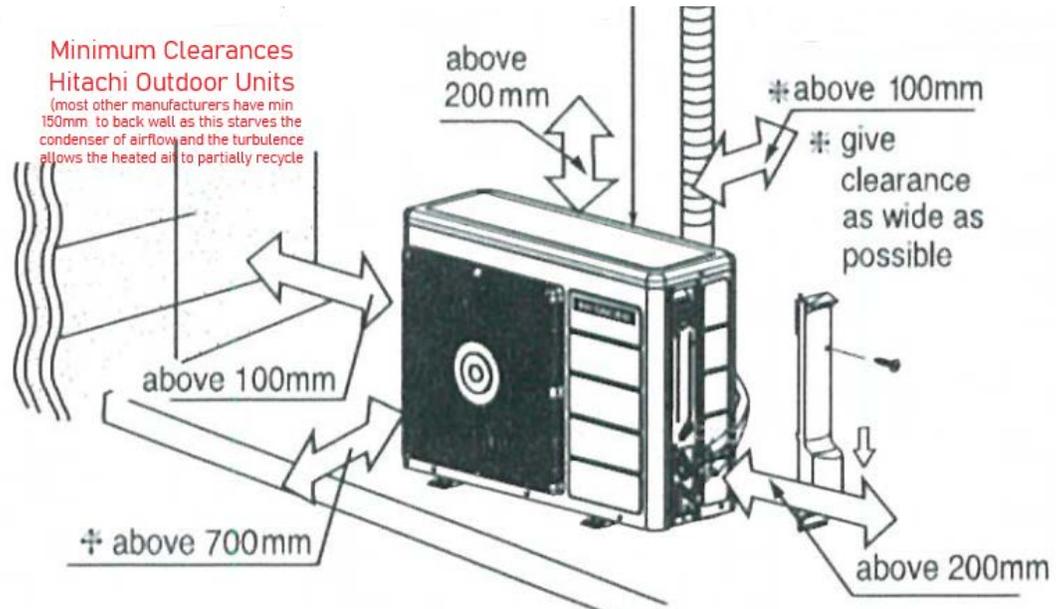

Other - Principal Certifier progress inspection sheet not done other than final  
Note that all signers of certificates and statements of conformance must have Professional Indemnity insurance cover or the Principal Cert is deemed liable.  
Note that Elect Statement and Mechanical Statement defined non-existent performance standards, rather than actual which questions their expertise.

Installation Instructions and Commissioning details not included in O&MM